



mp **Metropoint**
The Center for Business

Suite 450

4,544 RSF

400 S. Hwy 169

St. Louis Park, MN

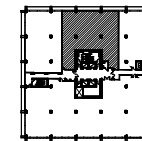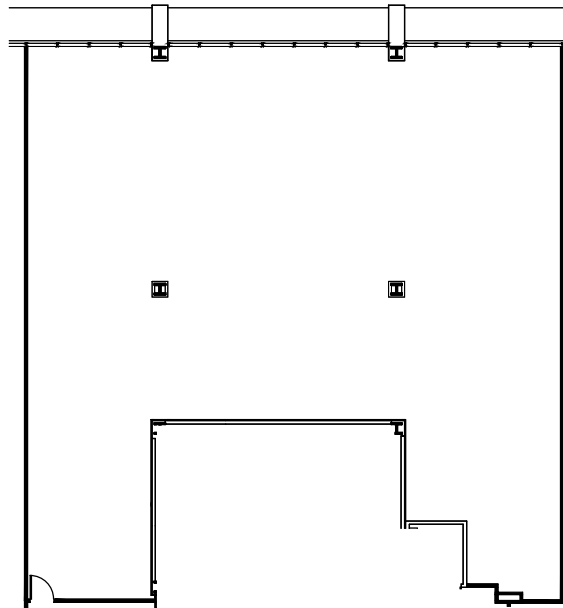

OWNED BY AN AFFILIATE OF
EQUUS
CAPITAL PARTNERS, LTD.

