




Metropoint

The Center for Business

Suite 350

7,815 RSF

300 Hwy 169 S
St. Louis Park, MN

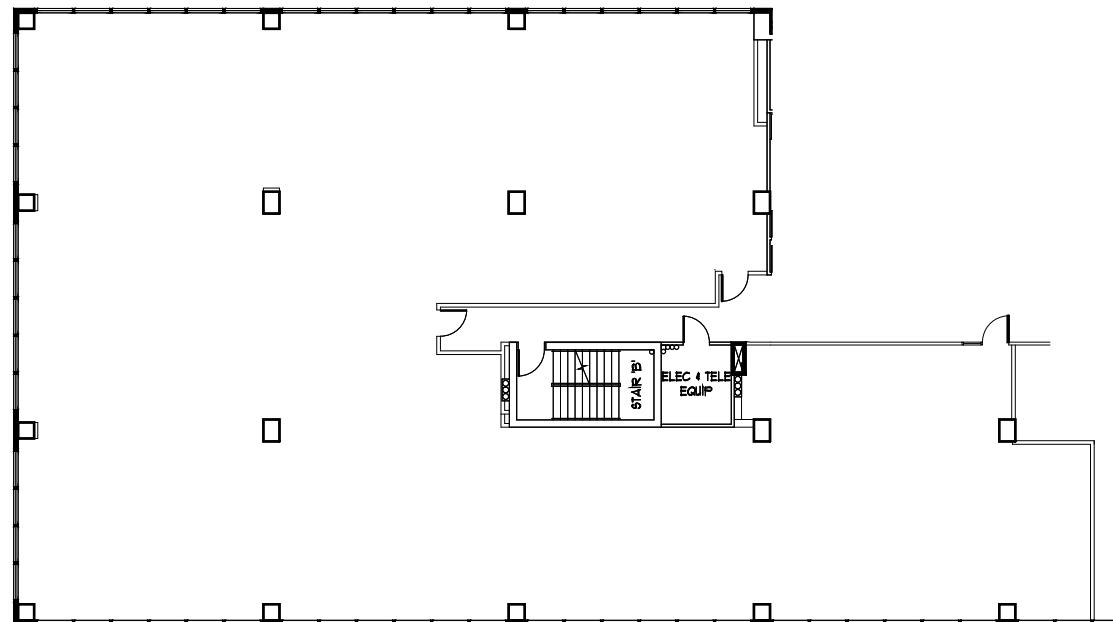

OWNED BY AN AFFILIATE OF
EQUUS  **CUSHMAN & WAKEFIELD®**
CAPITAL PARTNERS, LTD.

