



mp **Metropoint**
The Center for Business

Suite 710

3,127 RSF

600 S. Hwy 169

St. Louis Park, MN

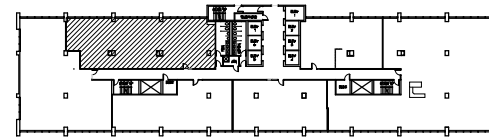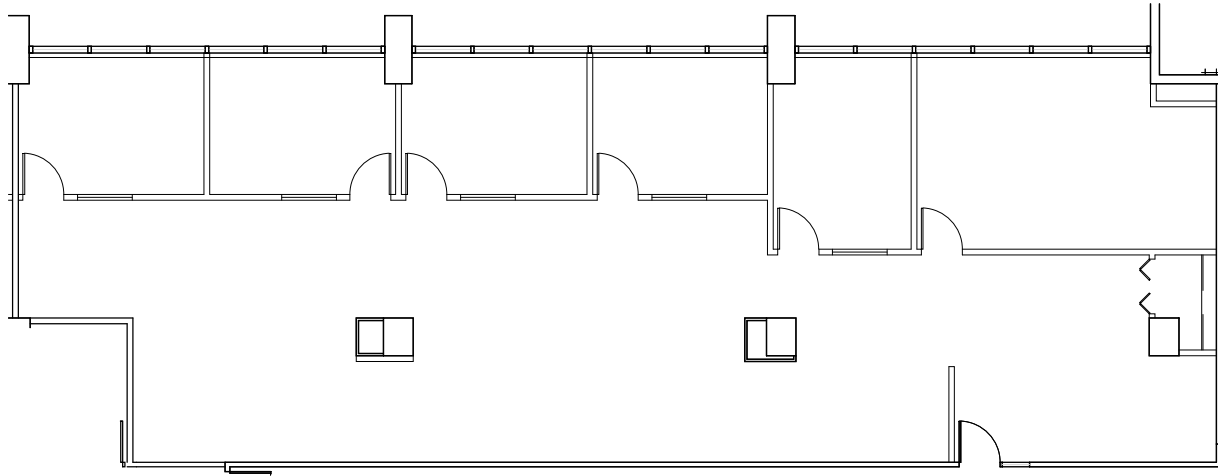

OWNED BY AN AFFILIATE OF
EQUUS **CUSHMAN & WAKEFIELD**
CAPITAL PARTNERS, LTD.